


Jul16/2020 3:16:05 PM

DHEC Aiken EQC 8036434027  
**APPROVAL TO OPERATE**  
Contractor Self-Inspection  
Onsite Wastewater System

1/2  
File No.: 2020010002  
County: Saluda



Name: Jeff Riboud Address: 3079 Windmill Rd Program Code: 360  
Type Facility: House Leeville, SC 29070 Tax Map: \_\_\_\_\_  
Subdivision: \_\_\_\_\_ Site: Longview Dr Lot 37 Water Supply: Public  
Block: \_\_\_\_\_ Lot: 37 Saluda, S.C.

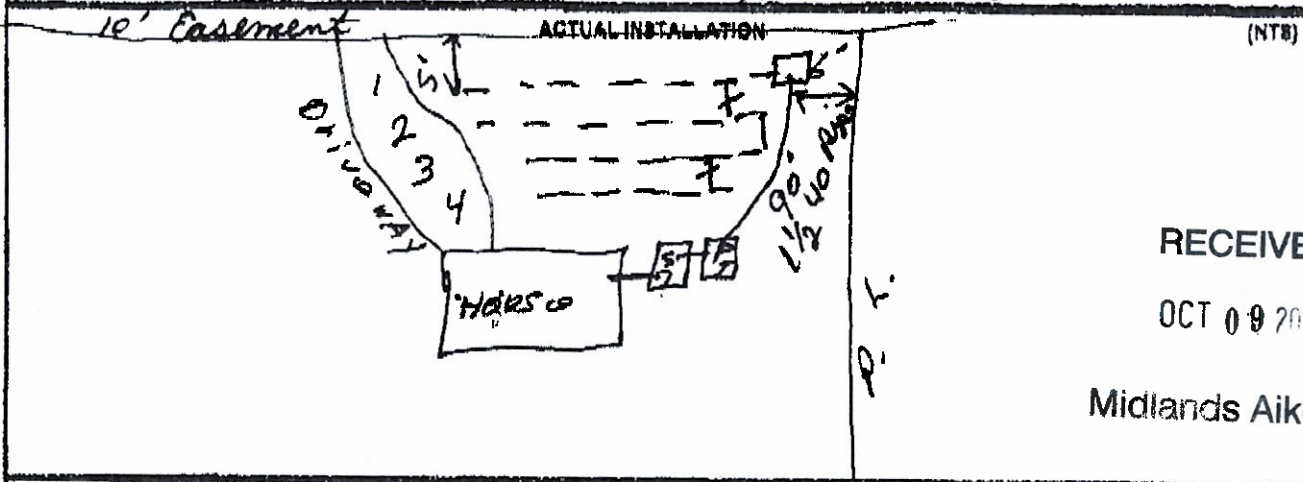

RECEIVED  
OCT 09 2020  
Midlands Aiken EA

**FINAL INSPECTION**  
Installer: Werts Backhoe & Septic Tank  
Septic Tank Mfr: Willingham Size: 1000 (gal)  
Pump Chmbr Mfr: Willingham Size: 1000 (gal)  
Pump Mfr: Liberty  
Pump Model: 280  
Grease Trap Mfr: \_\_\_\_\_  
Alternative Product: Standard infiltr.  
Aggregate Type: \_\_\_\_\_  
Aggregate Depth (in): \_\_\_\_\_  
Trench Width (in): 36"  
Trench Depth (in): 30"  
Fill Cap:  Yes  No Fill Cap Depth (in): \_\_\_\_\_  
Well Installed:  Yes  No  
Well Dist (ft): \_\_\_\_\_  
Building Dist (ft): 6'  
Property Dist (ft): 5'  
Water Dist (ft): 200'

Line No.	Cover	5.0
1-92'	6.1 6.1 6.1	14" 6.0
2-58'	6.8 6.8 6.8	19"
3-68'	6.8 6.8 6.8	14" 6.7
4-52'	7.1 7.1 7.1	14"

Comments: 13' lift from P.T. to drainfield

Contractor Printed Name: Eddie Werts License No.: 41-367-41010

I hereby certify the system was installed in accordance with the referenced permit and R.61-86.  
Contractor Signature: Eddie Werts Date: 10-8-20

Office Use Only: APPROVED AND SIGNED BY A DEPARTMENT REPRESENTATIVE  
Department Signature: Mary Ann Date: 10-9-2020