



# LAND RESOURCE MANAGEMENT


Land Evaluation by Land Experts

### SYSTEM SPECIFICATIONS

Est. Daily Flow (in GPD) 360 LTAR 25 Tank Size (Gallons) 1000 Pump Chamber Size (Gallons) 1000 Min. Pump Capacity      gpm @      feet of head ZSS (in inches)       
Water table encountered? Yes      No ✓

### Trenches

Total Number 5 Length (in feet) 360 Width (in inches) 36 Max. Depth (in inches)      aggregate mtl.      Aggregate Depth      Alternative product Std. Quick Infiltrator - 12"

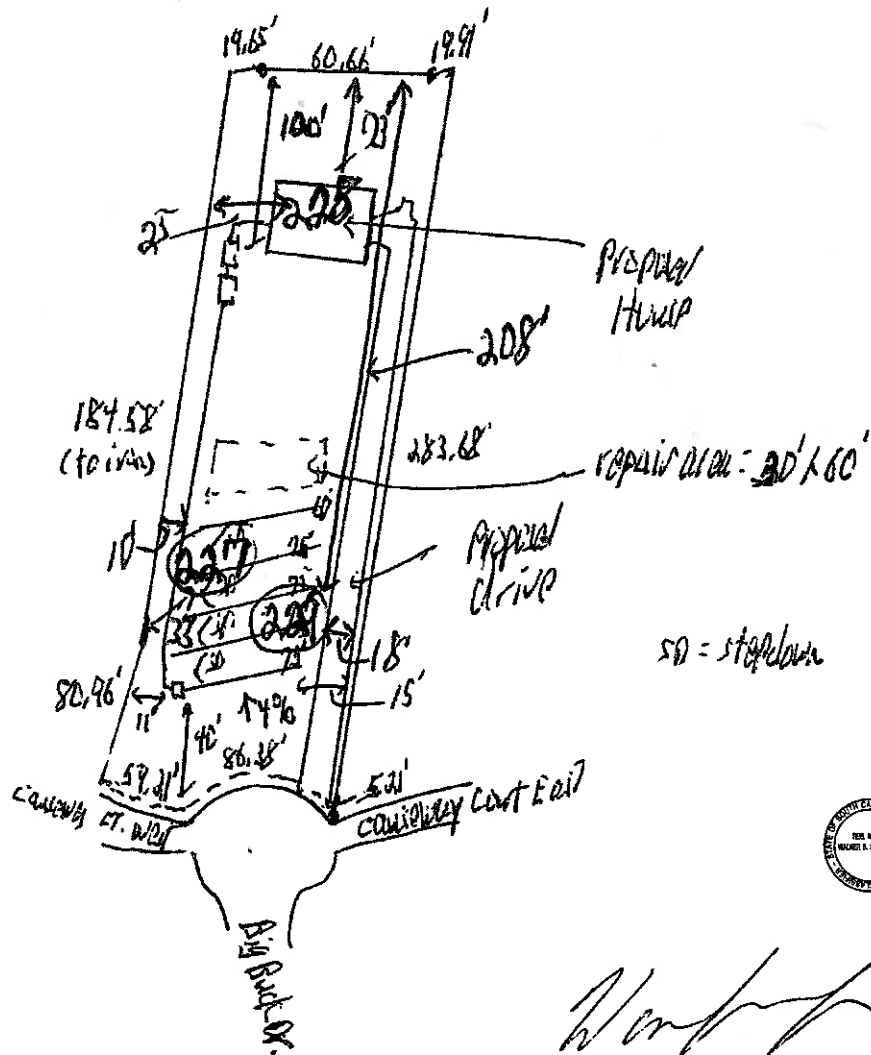

*[Handwritten signature]*

Palmetto Pointe  
Lot 66